






|                                                                                             |                                 |
|---------------------------------------------------------------------------------------------|---------------------------------|
| <b>AMELIA ISLAND COMPANY</b><br>VILLAGE PHASE 4                                             |                                 |
| <b>CONDOMINIUM LAYOUT</b><br>WITH<br>CATV, SEWER, F.WATER & BICYCLE<br>TRAIL EASEMENTS      |                                 |
| DATE<br>7-22-72                                                                             | REVISIONS<br>10/20/72 AS BUILT. |
| DRAWN BY<br>C.E.S.                                                                          | CHECKED BY<br>C.E.S.            |
| FILE NO.<br>10-794                                                                          | PROJECT NO.<br>10-794           |
| <b>BR</b><br>BARTON, HARRIS & REEDMAN, INC.<br>CONSULTING ENGINEERS<br>JACKSONVILLE - TAMPA |                                 |
| SHEET 4<br>OF<br>4                                                                          |                                 |

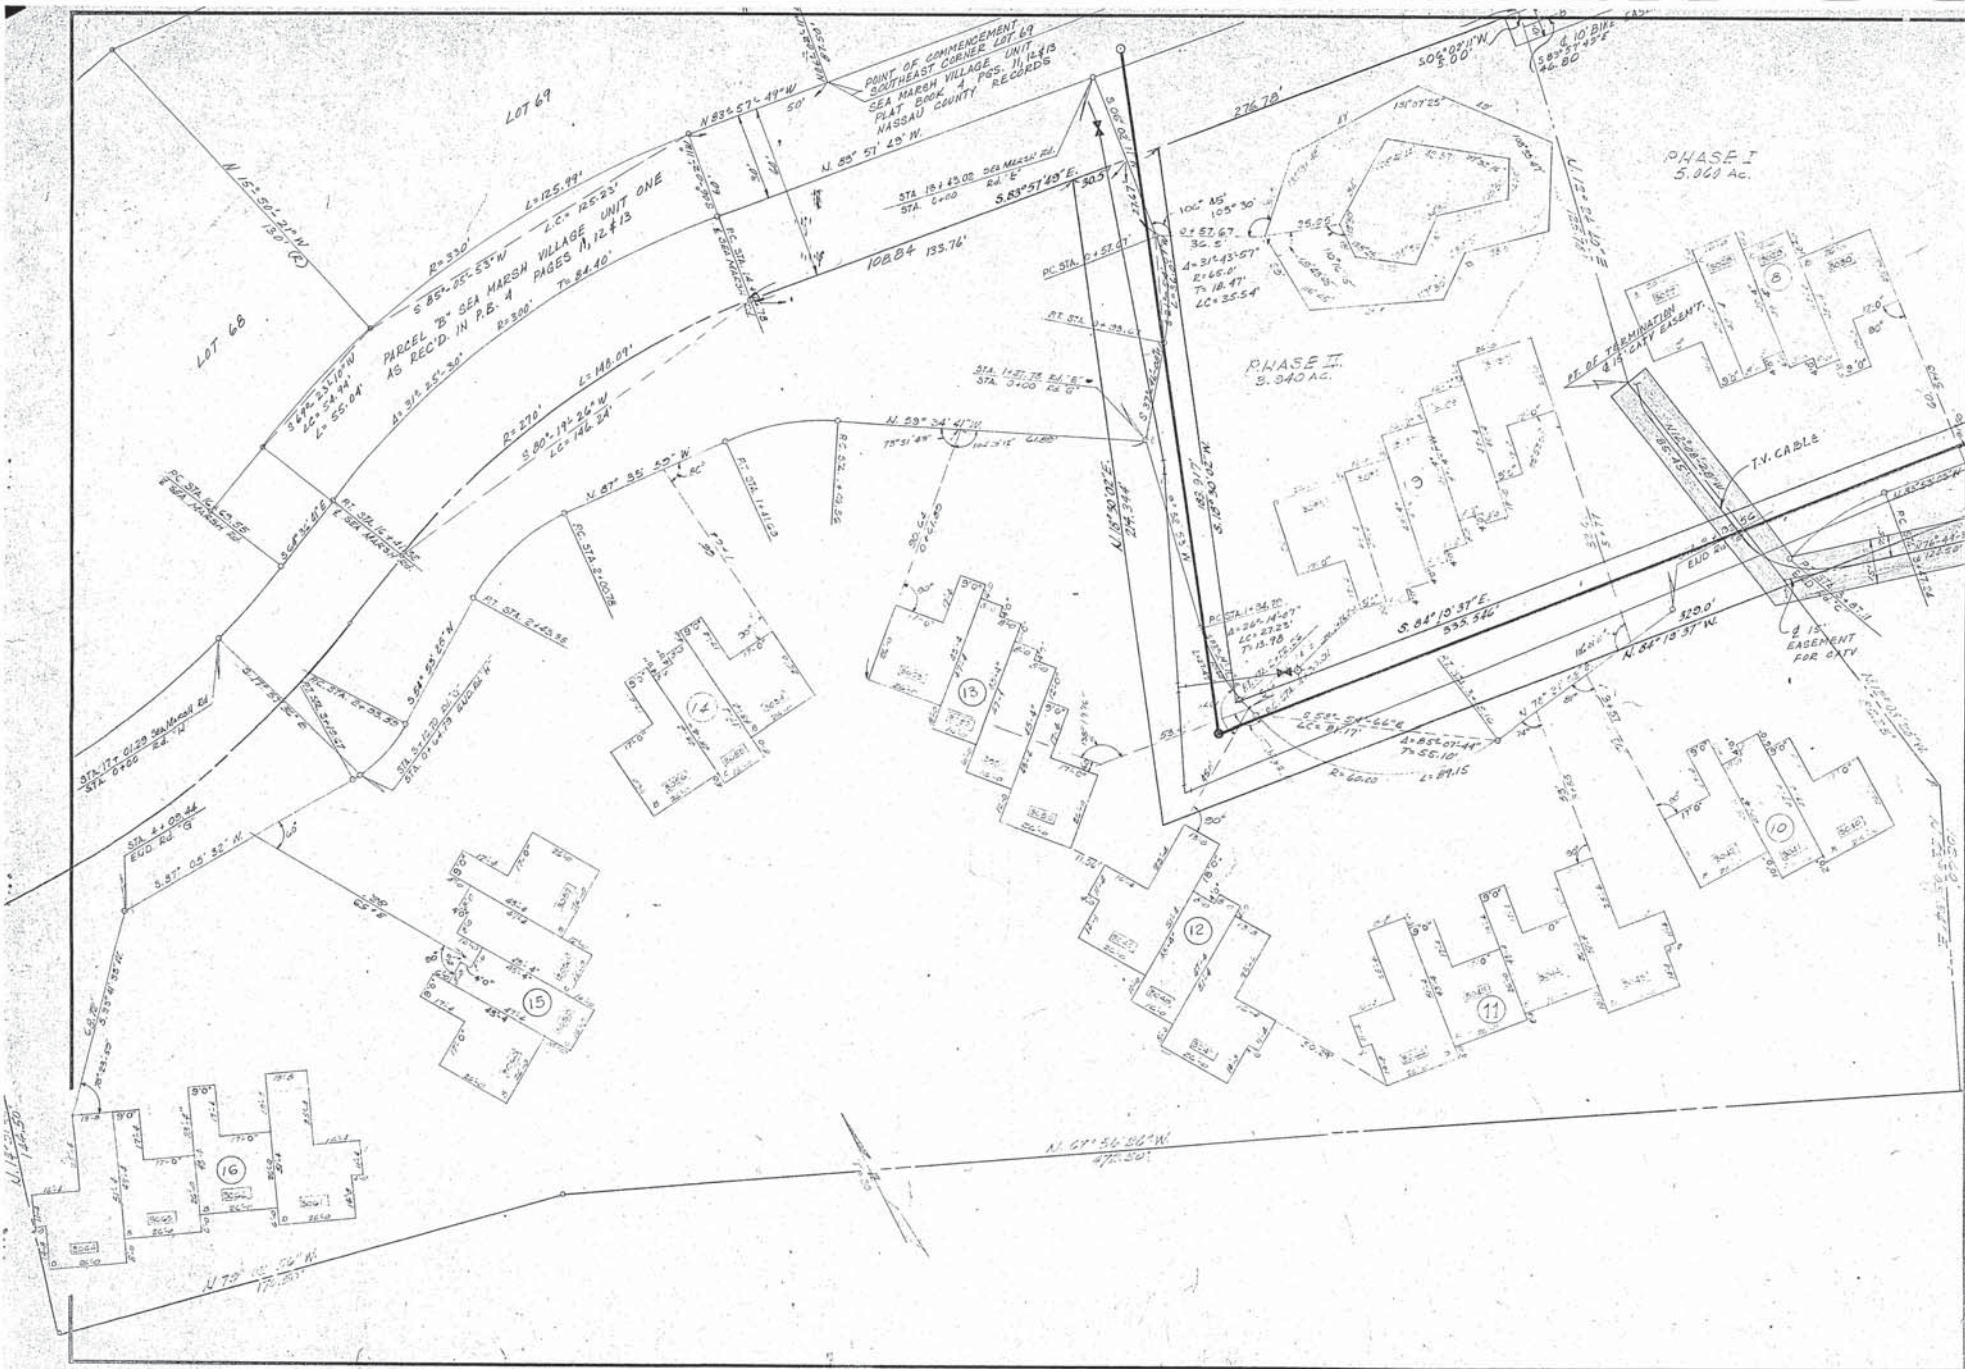